
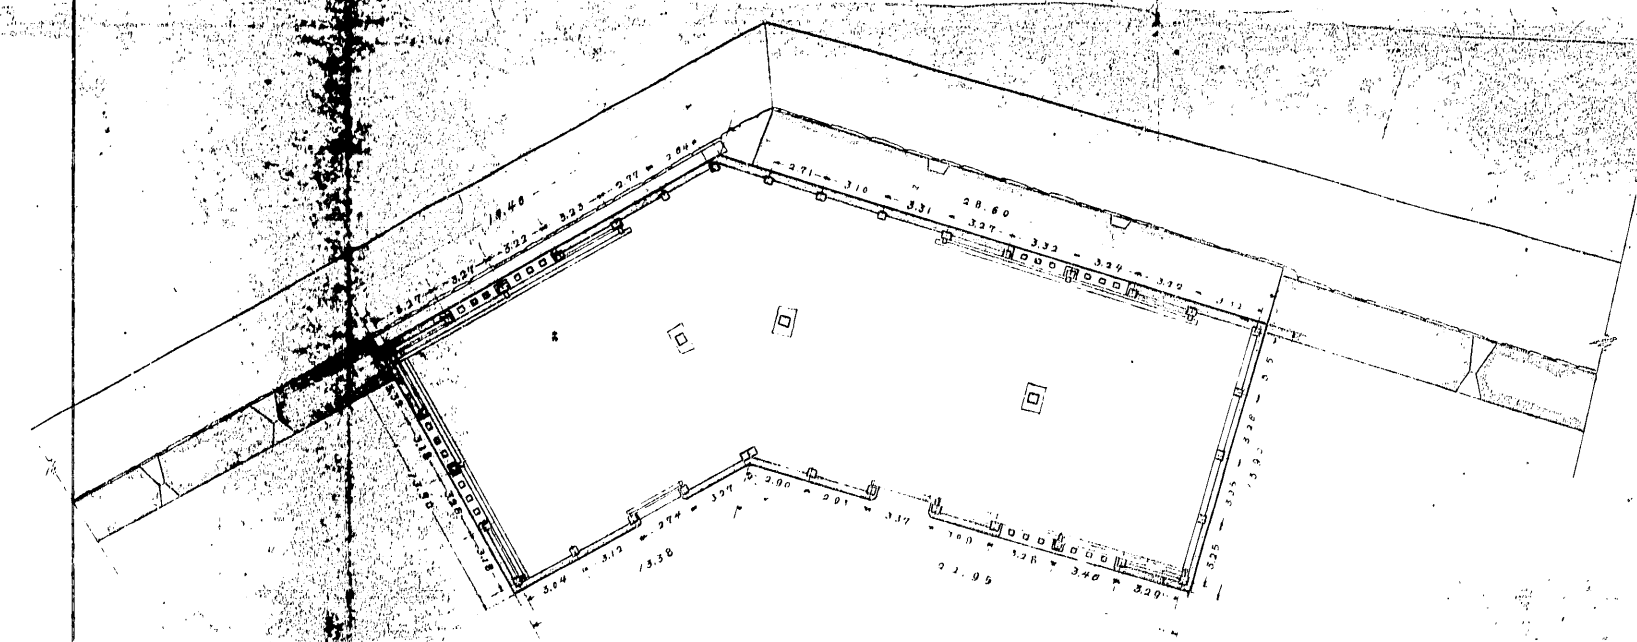
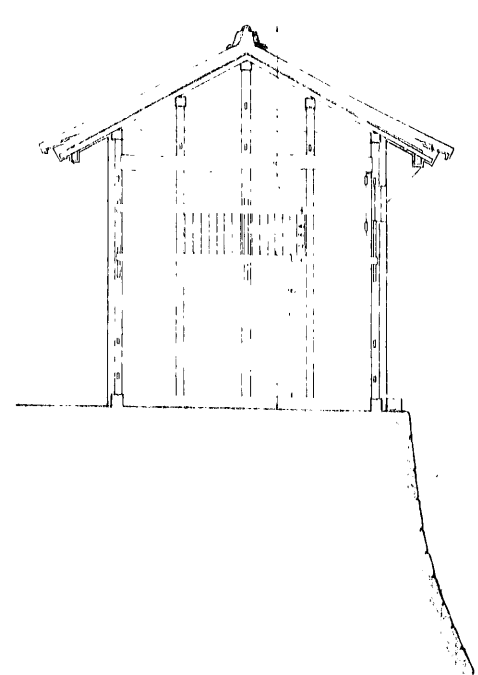
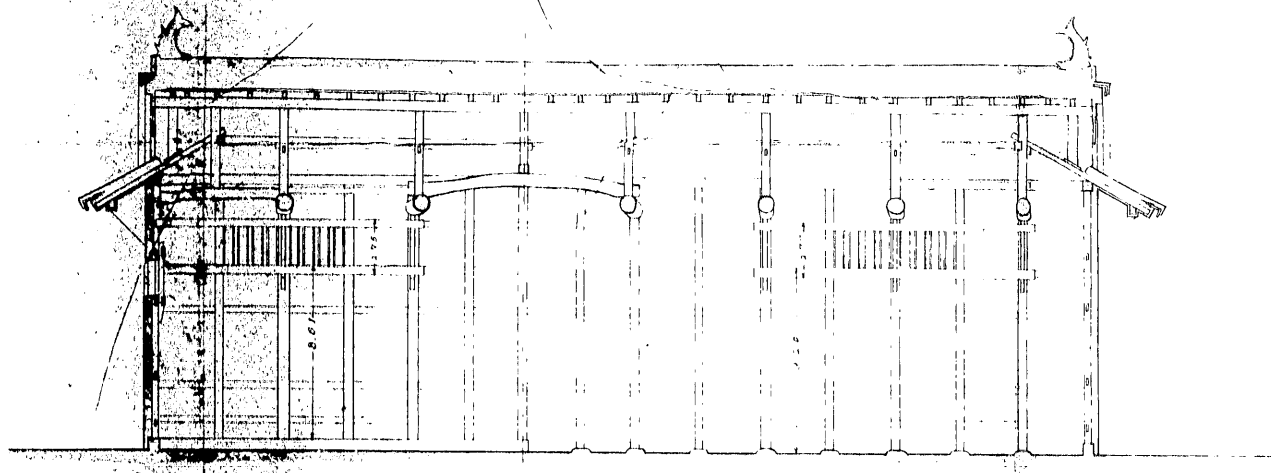


口ノ櫓竣工図

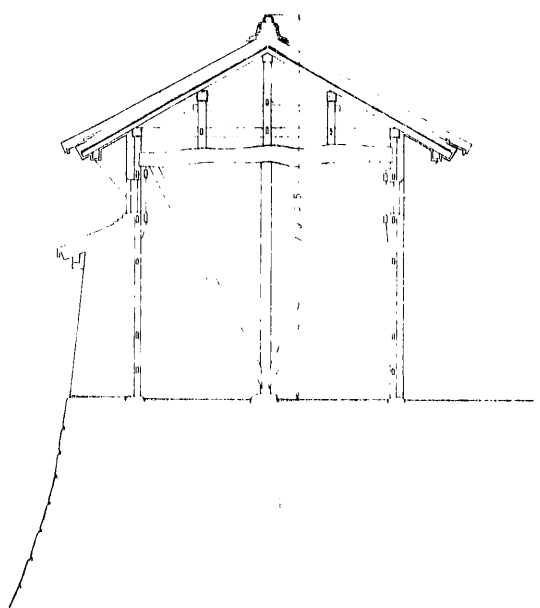

1/50